
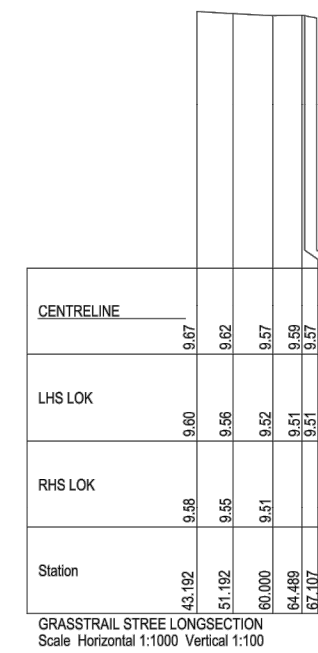
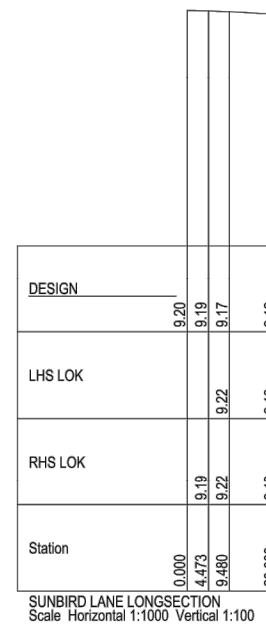
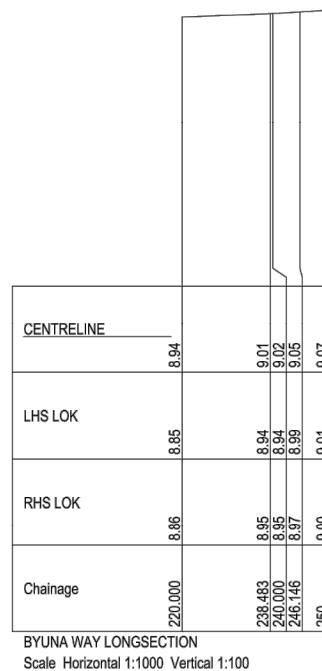
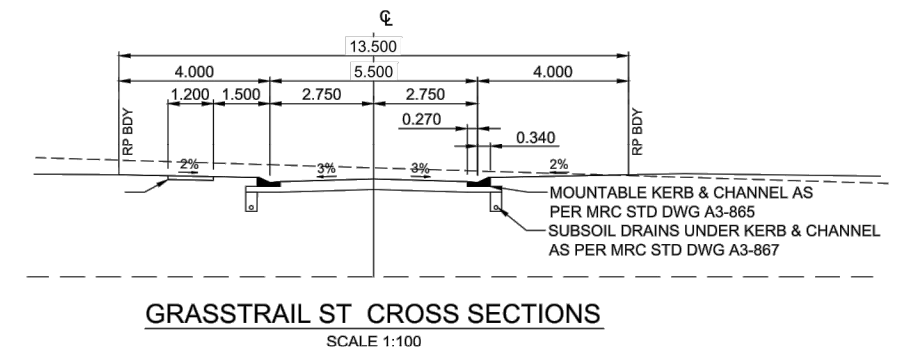
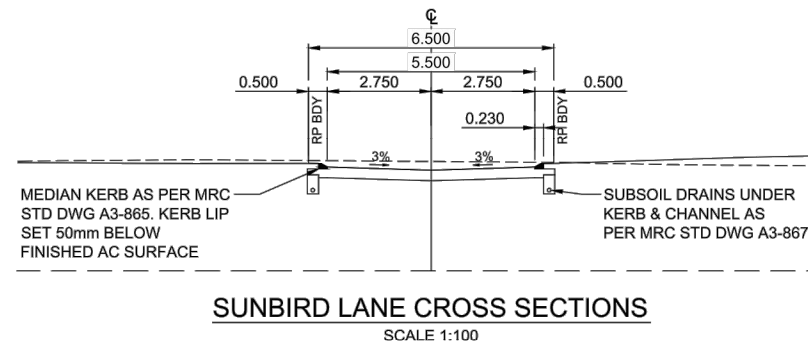


| BYUNA WAY | |
|-------------------------|-----------------|
| Actual CBR | 10 |
| Road Type | Minor Collector |
| Traffic ESA | 1 x 10^6 |
| Pavement Thickness (mm) | |
| AC Surfacing | 50 DG10 |
| Primer Seal | 7 |
| Base Course | 150 |
| Sub Base Course | 150 |
| Lower Sub Base | 150 min |
| Kerb & Channel | Mountable |

| SUNBIRD LANE | |
|-------------------------|----------------------|
| Actual CBR | 10 |
| Road Type | Laneway |
| Traffic ESA | 2 x 10^4 |
| Pavement Thickness (mm) | |
| AC Surfacing | 30 DG10 |
| Primer Seal | 7 |
| Base Course | 125 |
| Sub Base Course | 125 |
| Lower Sub Base | 75 min |
| Kerb & Channel | Embedded Median Kerb |

| GRASSTRAIL STREET | |
|-------------------------|-----------|
| Actual CBR | 10 |
| Road Type | Laneway |
| Traffic ESA | 2 x 10^4 |
| Pavement Thickness (mm) | |
| AC Surfacing | 30 DG10 |
| Primer Seal | 7 |
| Base Course | 125 |
| Sub Base Course | 125 |
| Lower Sub Base | 75 min |
| Kerb & Channel | Mountable |

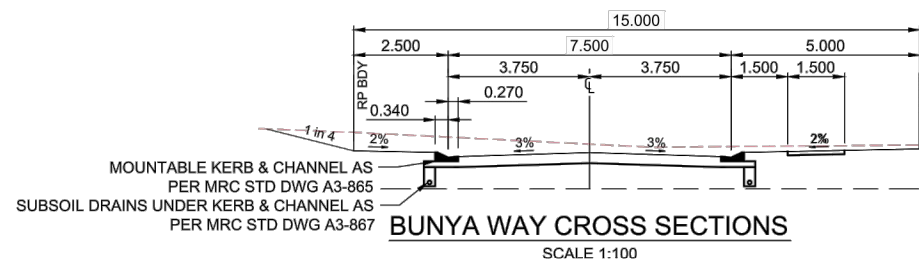

| Rev | Description | Drawn | Date | Checked | Date |
|-----|----------------------|-------|------------|---------|------------|
| A | As Constructed Issue | SD | 10.10.2013 | MF | 10.10.2013 |

This plan is prepared from a combination of field survey and existing records for the purpose of designing new constructions on the land and should not be used for any other purpose. The title boundaries shown hereon were not marked by the author at the time of survey and have been determined by plan dimensions only and not by field measurement. Services shown hereon have been located where possible by field survey. If not able to be located, services may have been plotted from the records of relevant authorities where available. Prior to any demolition, excavation or construction on the site, the relevant authority should be contacted for possible location of further underground services and detailed locations of all services. This note is an integral part of this plan.

AS CONSTRUCTED CERTIFICATION

APPROVED: 
MATTHEW BEGGS
 for and on behalf of BMD Consulting Pty Ltd

RPEQ: 5555


This drawing is an accurate representation of the works as constructed and the information is suitable for use by Council and others. The locations, surface and invert levels of all as-constructed works and infrastructure have been provided by Vision Surveys (QLD).

Registered Surveyor / Surveying Associate / Surveying Graduate

Certified By: **SAMANTHA DIVERS 5652**
 Date: 10 October 2013

AS CONSTRUCTED PLAN

DRAWING: ROAD TYPICAL CROSS SECTIONS
SHEET: 3 OF 9
PROJECT: STAGE 2, WOODLANDS ANDERGROVE
LOCATION: BEDFORD ROAD, ANDERGROVE
CLIENT: CIVIL CONTRACTORS AUST.



PO Box 1730 Mackay 4740
 Phone: (07) 4951 0768
 Email: mackay@visionsurveysqld.com.au

| | |
|---------------------------------|--------------------------------------|
| HORIZONTAL DATUM: MGA PSM 67982 | SCALE: NTS |
| VERTICAL DATUM: AHD 8.262 | DWG NUMBER: 12375 - S2 Asconstructed |
| SURVEYED: S DIVERS | REVISION: A |